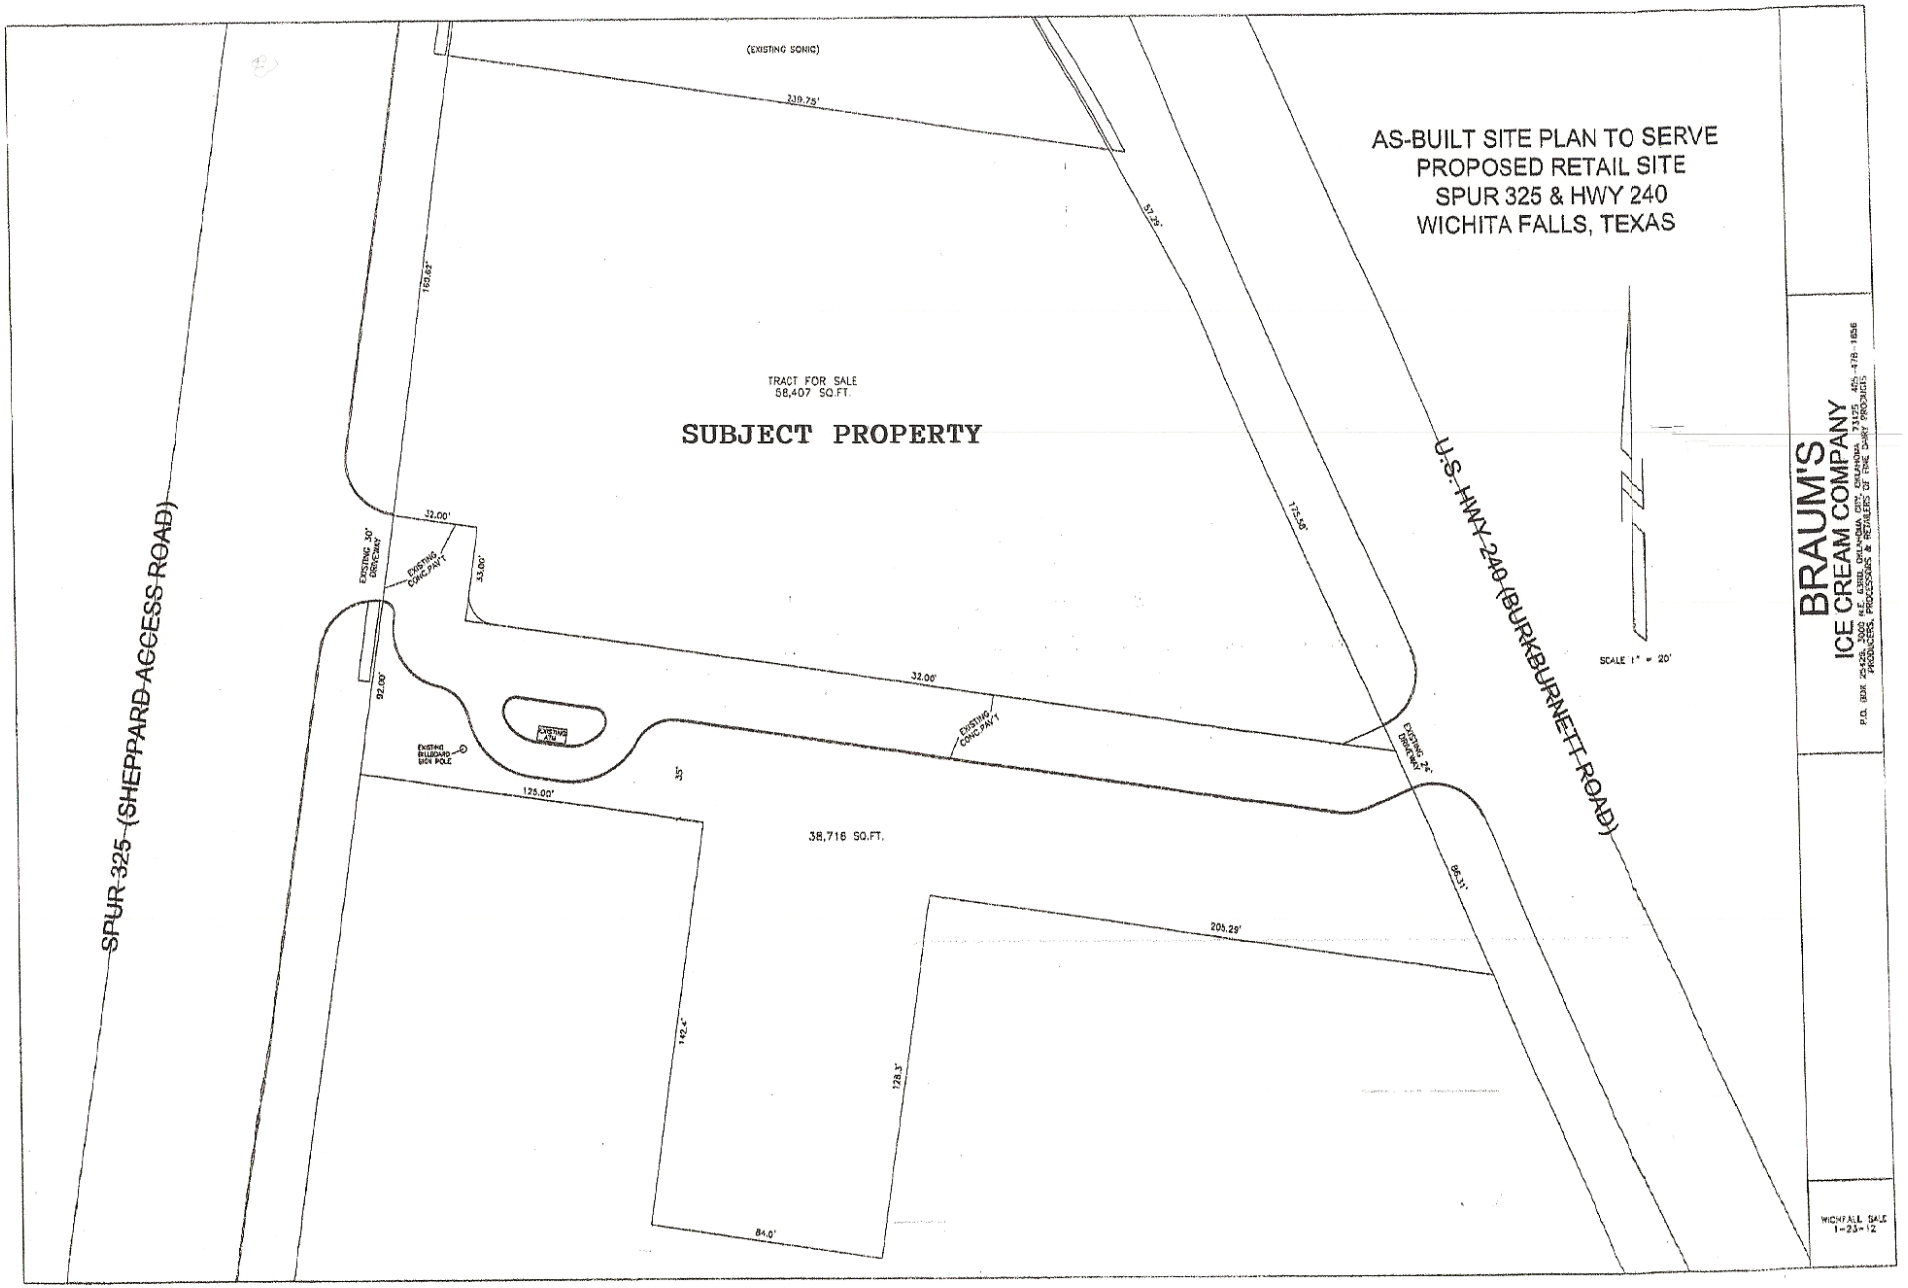
AS-BUILT SITE PLAN TO SERVE
PROPOSED RETAIL SITE
SPUR 325 & HWY 240
WICHITA FALLS, TEXAS
(EXISTING SONIC)
339.75'
57.35'
180.65'
TRACT FOR SALE
58,407 SQ.FT.
SUBJECT PROPERTY
175.58'
U.S. HWY 240 (BURKBURNETT ROAD)
SPUR 325 (SHEPPARD ACCESS ROAD)
32.00'
EXISTING 30' DRIVEWAY
EXISTING CONC.PAV'T
33.00'
92.00'
32.00'
EXISTING CONC.PAV'T
EXISTING 24' DRIVEWAY
EXISTING BILLBOARD SIGN POLE
35'
125.00'
38,716 SQ.FT.
86.31'
205.29'
142.4'
128.3'
84.0'
SCALE 1" = 20'
BRAUM'S
ICE CREAM COMPANY
P.O. BOX 25425, 3000 N.E. 63RD, OKLAHOMA CITY, OKLAHOMA 73125 405-478-1656
PRODUCERS, PROCESSORS & RETAILERS OF FINE DAIRY PRODUCTS
WICHITA FALLS, SALE
1-23-12